

VALVE & INSTRUMENT LIST					
NO	DESCRIPTION	MATERIAL	Q'TY	SIZE	REMARK
1	VAPORIZER	SUS304 & A6063S-T5	2		100NM3/H
2	LINE V/V	BC7	8	25A	30K, LONG STEM GLOBE
3	LINE V/V	BC7	5	15A	30K, LONG STEM GLOBE
4	LINE SAFETY V/V	STS304 / BC6	4	15A	SP= 2.0MPa
5	LINE SAFETY V/V	BS	1	15A	SP= 0.52MPa
6	PRESSURE GAUGE	STS304	2	15A	0~3MPa
7	PRESSURE GAUGE	STS304	2	15A	0~1MPa
8	REGULATOR	BC7	2	25A	RANGE: 0~1 MPa, 230NM3/HR
9	LINE V/V	BC7	2	15A	STS BALL V/V, 10K
10	STS TUBE	STS304	LS	25A	Sch #20
11	STS TUBE	STS304	LS	15A	Sch #20
12	FLANGE	STS304	8	15A	20K
13	COPPER TUBE	KS D 5301	LS	80A	"L" TYPE

PROJECT TITLE  
한림대학교한강성심병원  
본관 증축 및 대수선공사

ARCHITECTURAL  
**HEESANG**  
희상건설

희상건설 주식회사  
TEL : (02) 567-0488  
FAX : (02) 567-0458  
Web : www.heesang.net

STRUCTURAL  
희상건설 주식회사  
TEL: (02) 567-0488 FAX: (02) 567-0458  
CIVIL ENGINEERING

LANDSCAPING

MECHANICAL

ELECTRICAL

INFORMATION TELECOMMUNICATION

FIRE PROTECTION

NOTE.

NO	DESCRIPTION	DATE
ISSUES & REVISIONS		

DRAWING TITLE  
본관 1층  
옥외 산소 저장소 배치도

DRAWN	SCALE
	1/25(50)


CHECK	SHEET NO.

DATE	PROJECT NO.

DRAWING NO.

본관 1층 옥외 산소 저장소 배치도

축척: A1=1/25(A3=1/50)

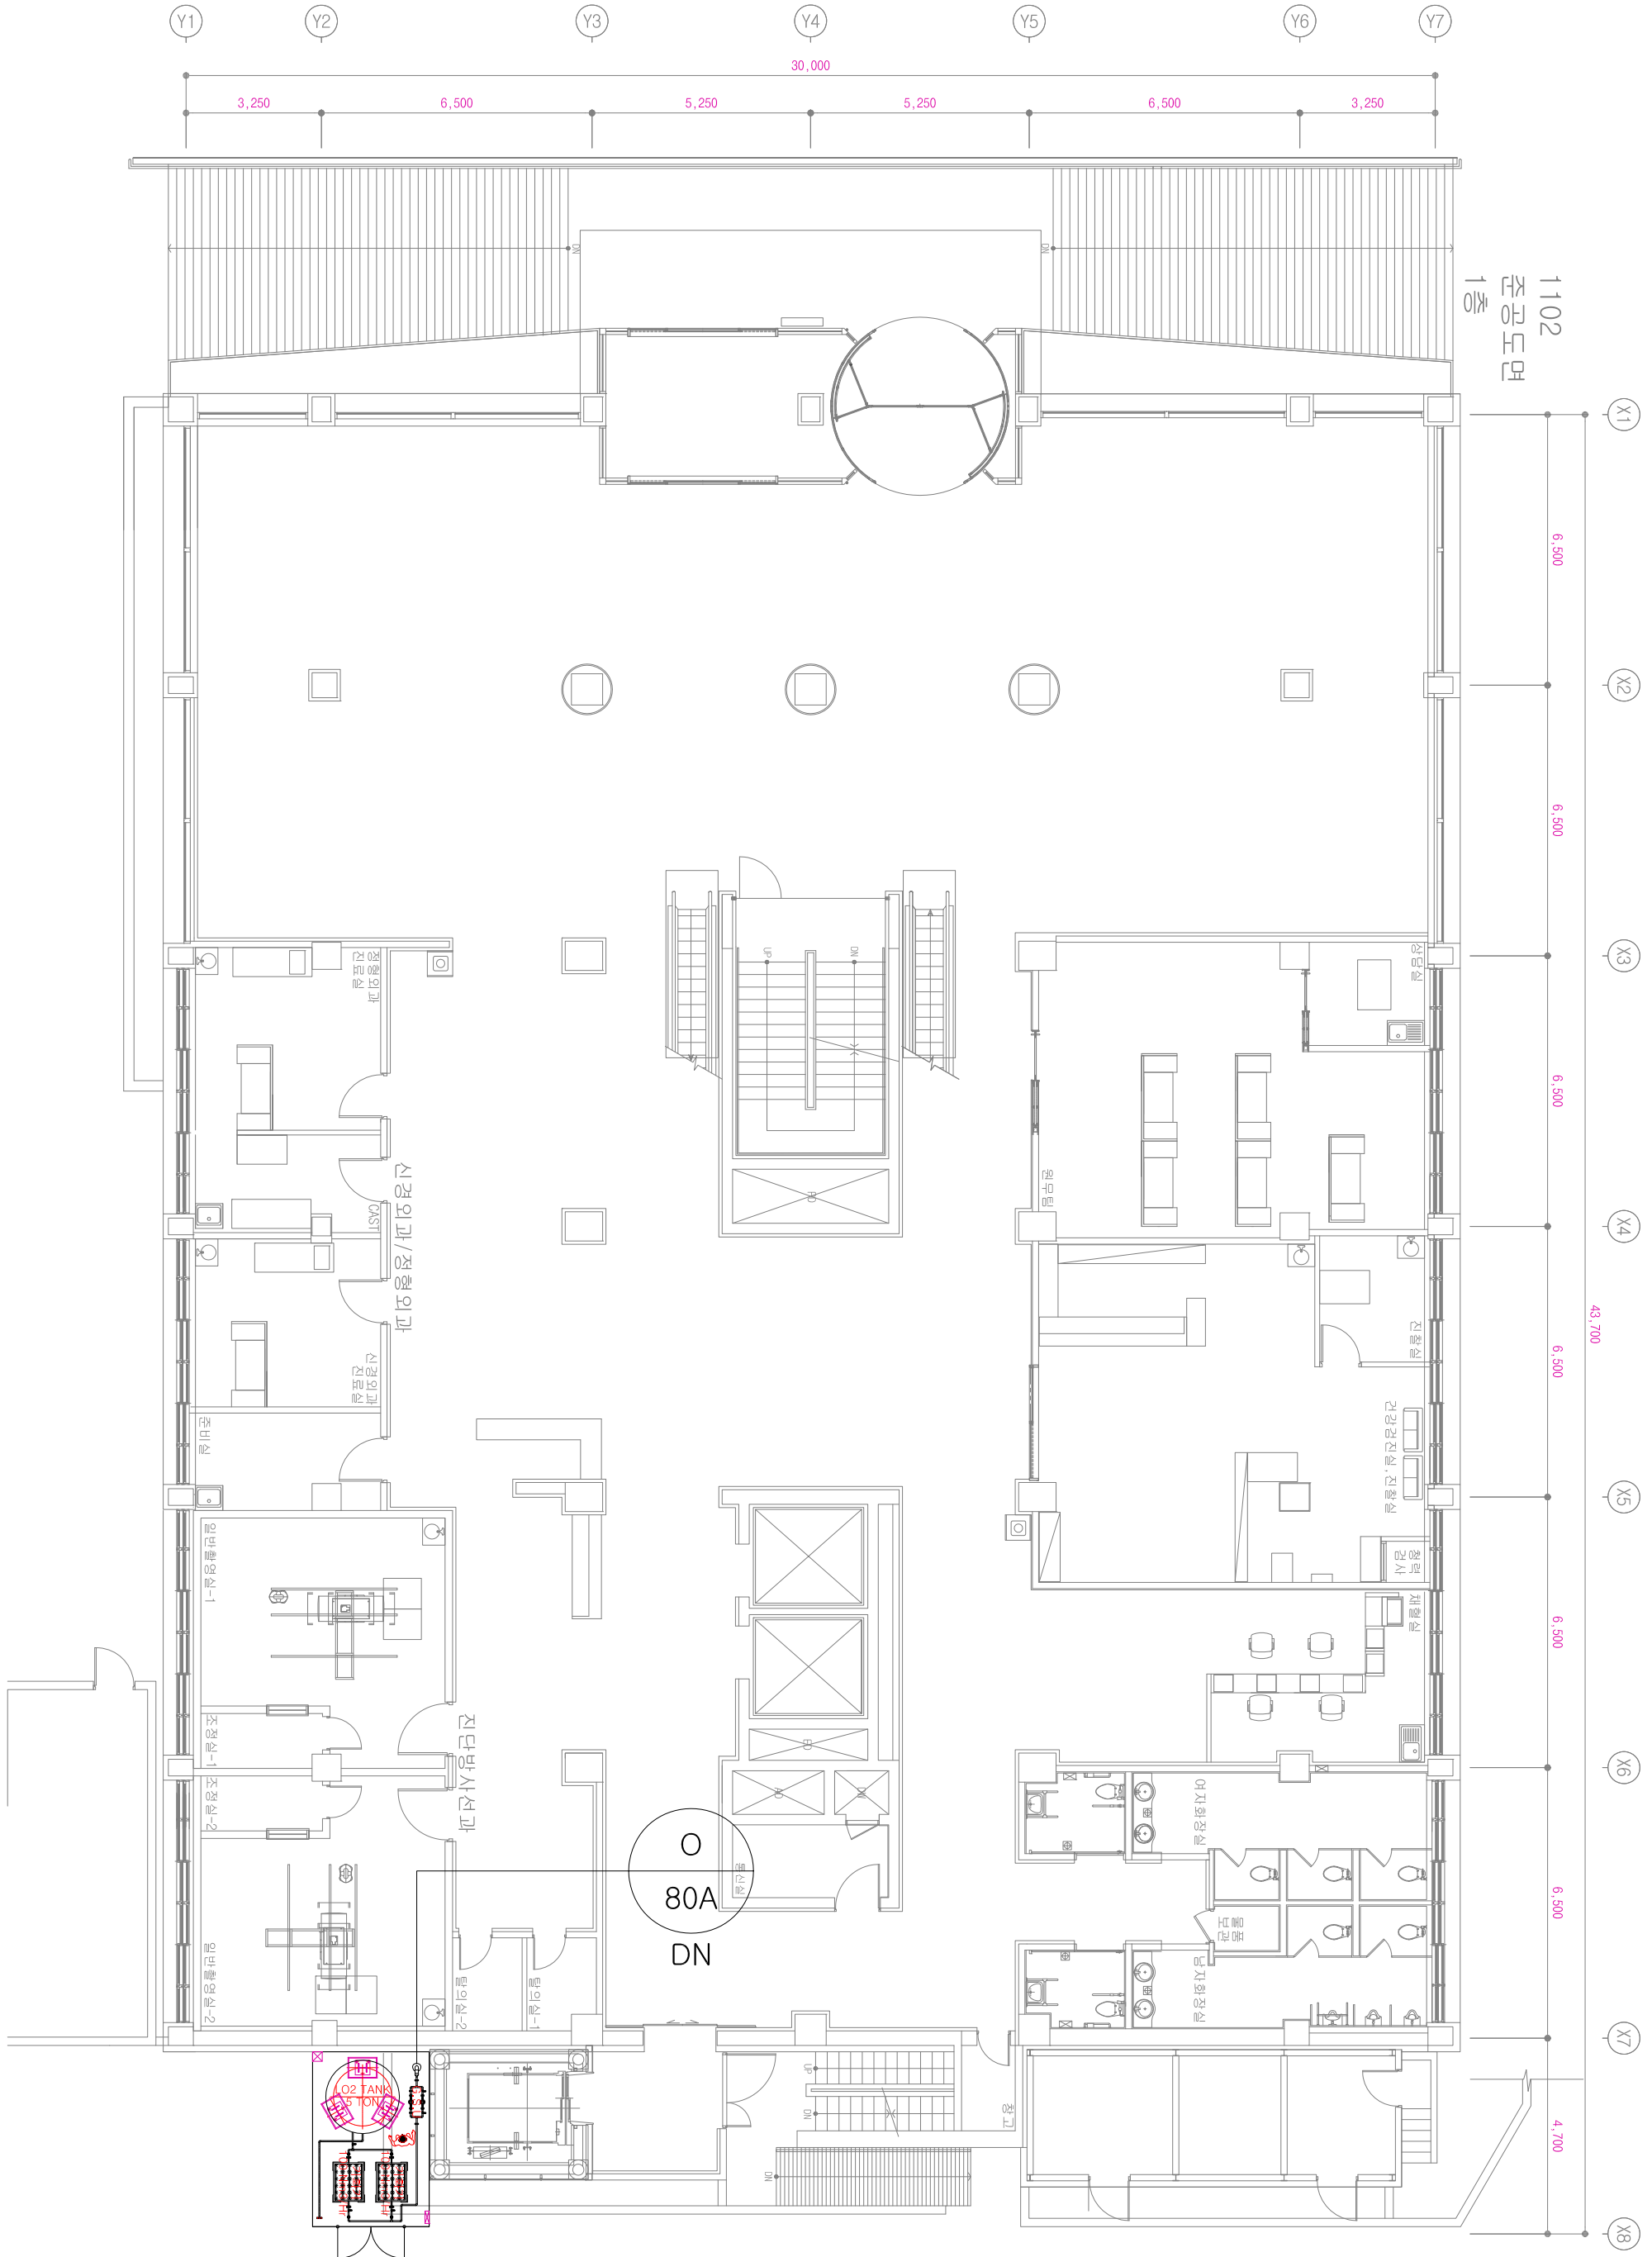

Y1

Y2

Y3

Y4

Y5

Y6

Y7

30,000

3,250

6,500

5,250

5,250

6,500

3,250

1102  
준공도면  
1층

X1

6,500

X2

6,500

X3

6,500

X4

43,700

X5

6,500

X6

6,500

X7

4,700

X8

O  
80A  
DN

O2 TANK  
15 TONS

